


Title:		Date: 07-31-2015
Scale: 1 inch = 468 feet	File:	
Tract 1: 21.500 Acres: 936528 Sq Feet: Closure = s42.3631w 0.10 Feet: Precision = 1/45368: Perimeter = 4335 Feet		
001=n41.0044e 344.02	004=s48.1018e 934.87	007=n47.3758w 573.77
002=n48.0341w 646.24	005=s47.2500e 290.32	
003=n42.4345e 599.69	006=s42.2458w 946.37	

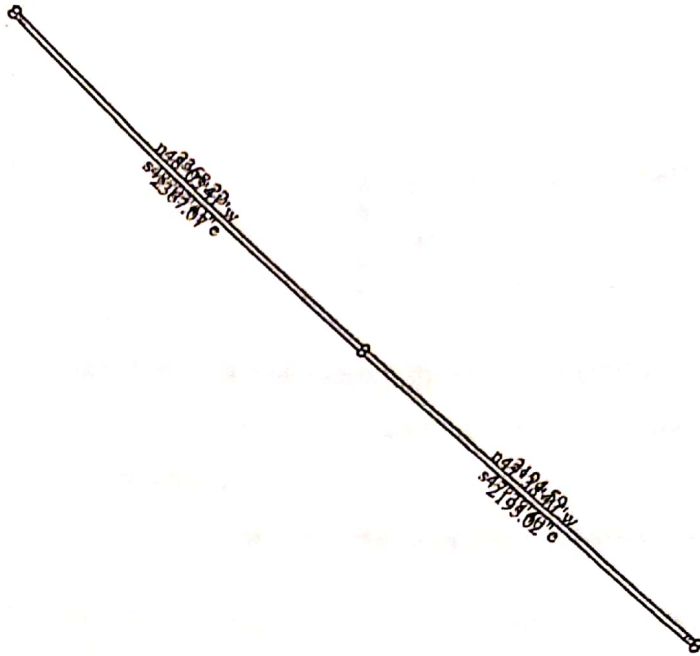

Title:		Date: 07-31-2015
Scale: 1 inch = 948 feet	File:	
Tract 1: 3.142 Acres: 136864 Sq Feet: Closure = s47.5743e 0.00 Feet: Precision >1/999999: Perimeter = 9185 Feet		
001=s48.0341e 2368.22	004=n47.3840w 2195.02	
002=s47.3840e 2194.59	005=n48.0341w 2367.07	
003=s42.2300w 30.00	006=n41.0000e 30.	

SURVEY MAP OF:


**21.498 ACRES OF LAND OUT OF THE
LEROY WOOD SURVEY, ABSTRACT NO.
200322, IN LEE COUNTY, TEXAS, AND BEING
THAT PART OF SAID ACRES TRACT OF LAND
CONVEYED TO MARY JEAN KOHLER AND
RICHARD L. KOHLER BY A DEED AS RECORDED
IN VOLUME 600 PAGE 400 OF THE DEED RECORDS
OF LEE COUNTY, TEXAS.**

SEE ACCOMPANYING FIELD NOTE DESCRIPTION

LEGEND

- 1/2" Iron Rod Found
- 1/2" Iron Pipe Found
- Wire Fence
- Wood Fence
- Existing Utility Line
- Record Bearing & Distance

NOTE: This property is subject to a blanket
type assessment for water lines as described
and recorded in Volume 199 Page 190 of
the Real Property Records of Lee County,
Texas, this assessment is limited to 15" in width
centered on the pipes as installed.

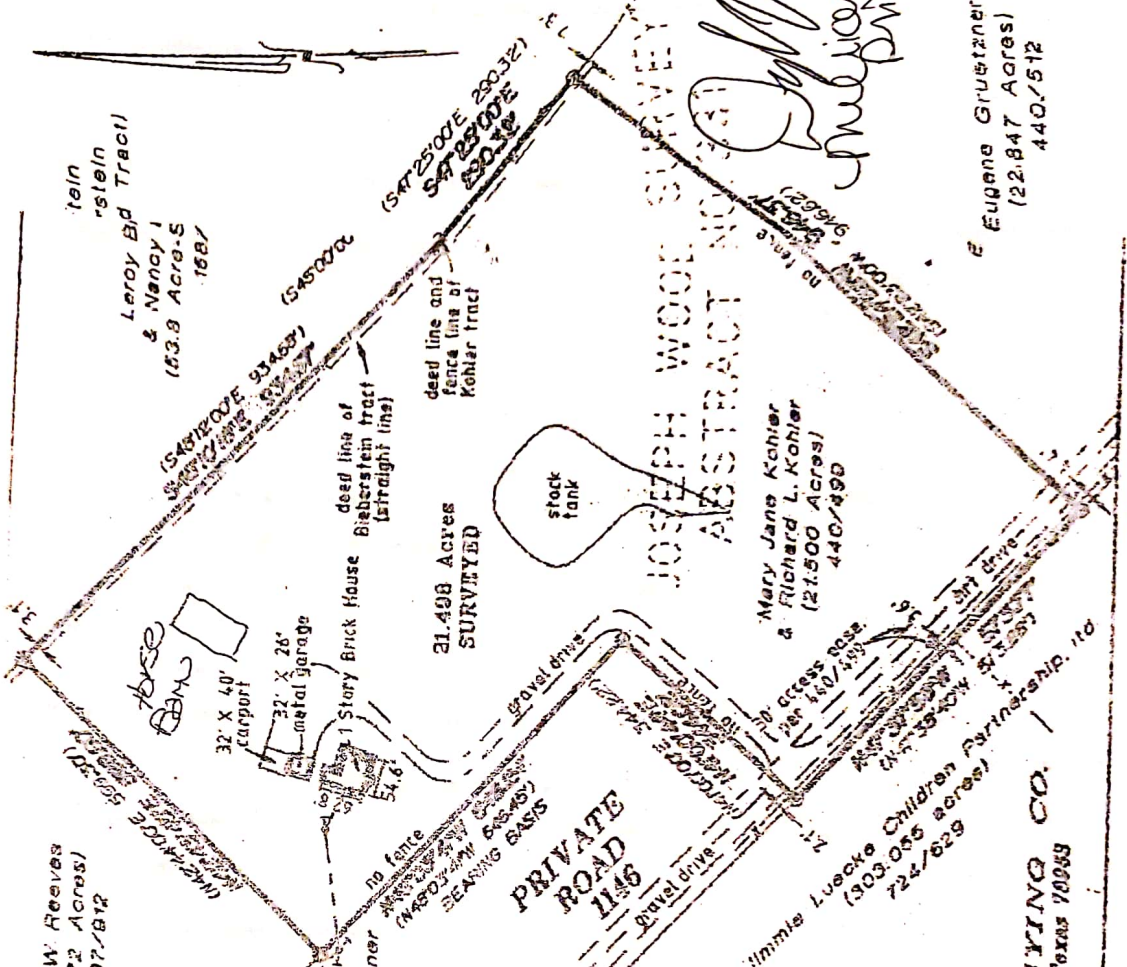

TO Michael Dean Joseph
Lee County Land & Abstract Co
IG.F. No. 2092-1641

THE STATE OF TEXAS
COUNTY OF FAYETTE

The undersigned does hereby certify that a survey was this day made on
the ground of the property legally described hereon and is correct and that
there are no boundary line conflicts, encroachments, shortages in area,
overlapping of improvements, visible utility lines, or roads in place, except
as shown hereon, and said property has access to and from a dedicated road
No portion of this property lies within a special flood hazard area (Zone X)
according to the Federal Emergency Management Agency Flood Insurance Rate Map
LA0501 2008 A, dated November 16, 1997
THIS the 1st day of April, 2002

Eugene Gruetzner
Surveyor
No. 10707
Exp. 12/31/04

FIELANTYIGE SURVEYING CO.
727 West Point Loop, West Point, Texas 70989
(979) 342-3460